



ENGINEERING CLARIFICATION

EC TITLE: Removal of Electric Trap Primer Note
PROJECT: 3 Kings Water Treatment Plant

EC NO.: 60
DATE: 8/21/2020
STATUS: Open

SECTION 1: BY CONTRACTOR

QUESTION:

Note 1 on Dwg. 300-P-2001 is not necessary as there is no electric trap primer in this area.

DRAWING NO.: 300-P-2001 PLUMBING - FACILITY 300 -
AREA 310 - BWW CLARIFIERS - PLAN

SPECIFICATION SECTION:

POTENTIAL COST IMPACT:

POTENTIAL SCHEDULE IMPACT:

PROPOSED SOLUTION:

See attached markups.

COMMENTS:

INITIATOR: Zalla, Joseph/SLC

PRIORITY: Normal

REQUESTED RESPONSE DATE: 9/4/2020

SECTION 2: BY REVIEWER

RESPONSE:


COMMENTS:

REVIEWED BY:

REVIEWED DATE:

GENERAL NOTES

1. ALL TRENCH DRAINS AND FLOOR DRAINS SHALL BE PROVIDED WITH ELECTRIC TRAP PRIMER CONNECTIONS (2213-411)

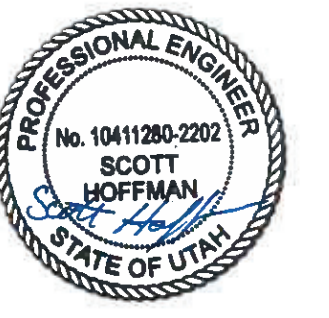

DIGITALLY SIGNED:
02/10/2020

NO.	1	DATE	08/21/2020	REVISION	ENGINEERING CLARIFICATION #60
BY	JZ	CHK	BY	APVD	
DR	S. HOFFMAN	DR	T. WHITE	CHK	APVD
DR	M. DRAGON	APVD			



ZEHREN AND ASSOCIATES, INC.
LANDSCAPE ARCHITECTURE
ARCHITECTURE PLANNING INTERIORS
100 West Center Street, Suite 200
P.O. Box 1970, Arvada, Colorado 80006
303.426.4227 FAX 303.426.4200

3Kings WTP Phase III Design
Park City Municipal Corporation
Park City, Utah

JACOBS

PLUMBING
FACILITY 300 - AREA 310
BWW CLARIFIERS
PLAN

VERIFY SCALE	
DATE	02/10/2020
PROJ	694342
DWG	300-P-2001
SHEET	689 of 911

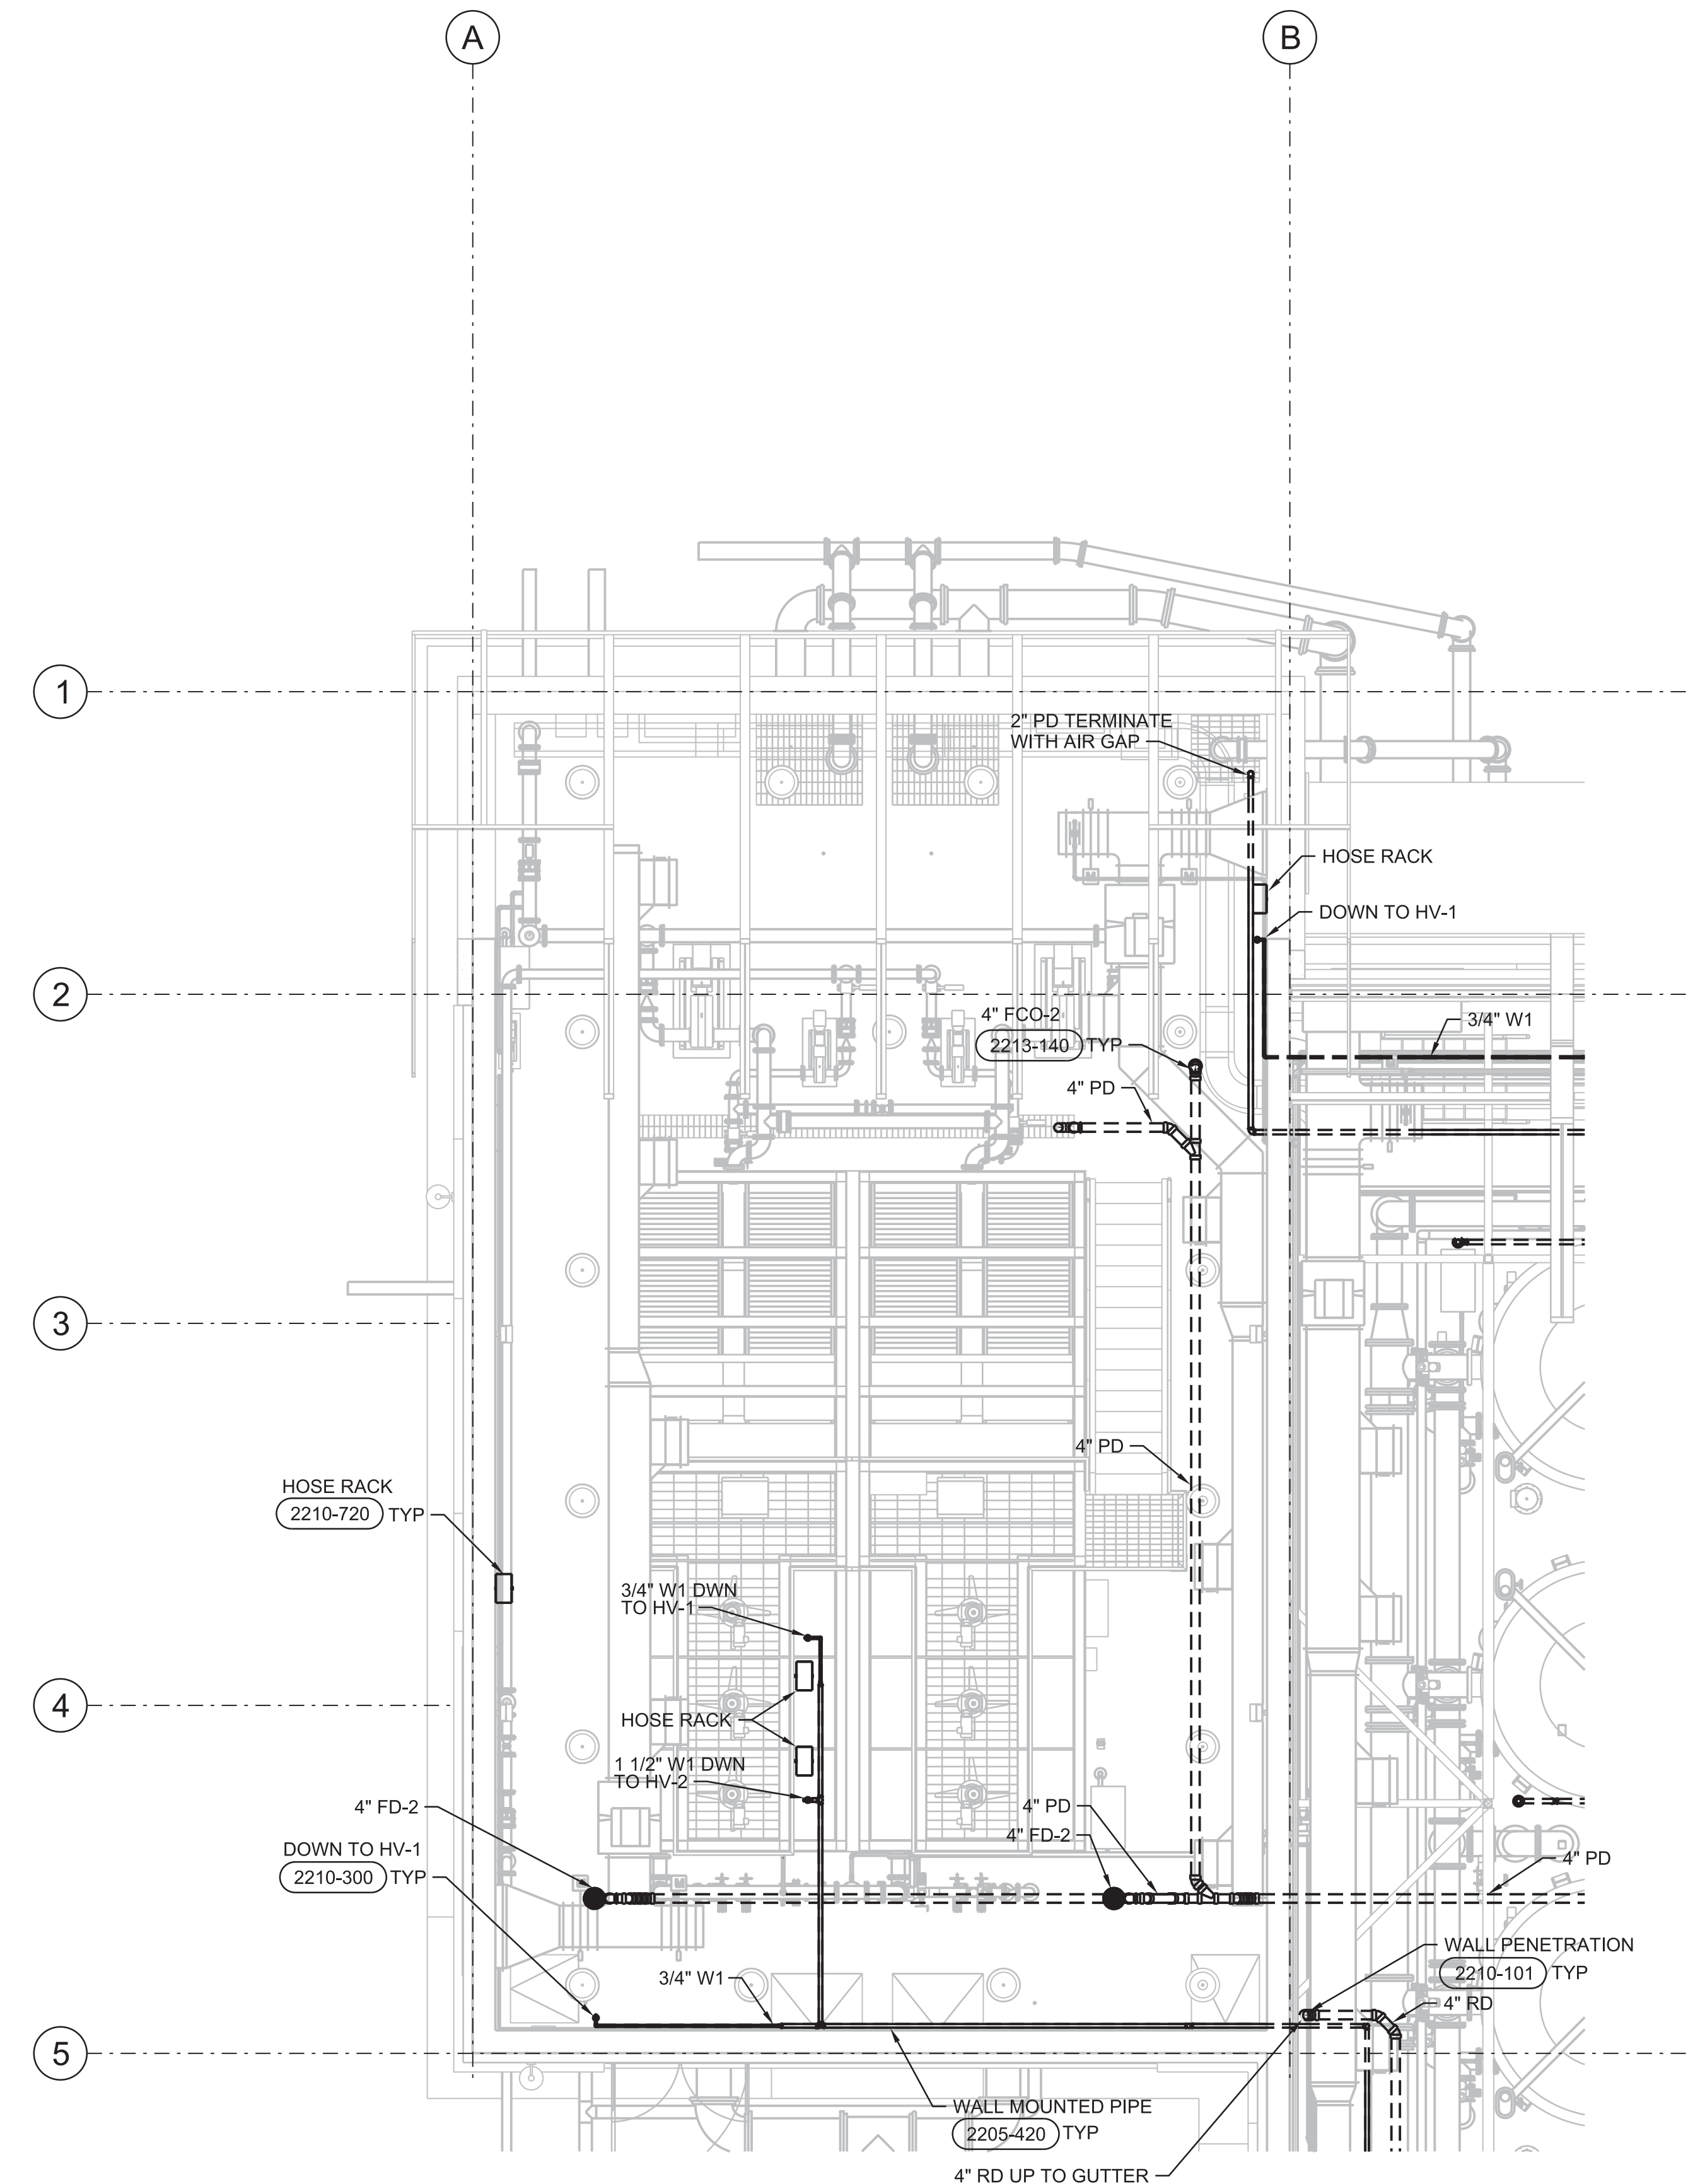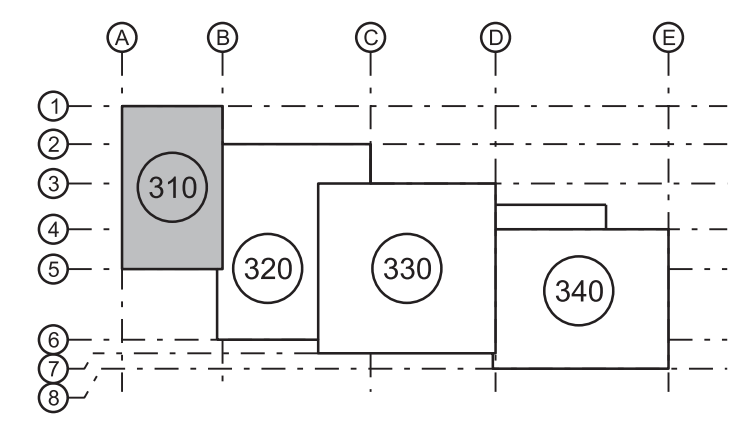

PLAN
3/16"=1'-0"

ISSUED FOR CONSTRUCTION