



ENGINEERING CLARIFICATION

EC TITLE: Facility 400 UV CPP and Transformer Layout
PROJECT: 3 Kings Water Treatment Plant

EC NO.: 64
DATE: 9/1/2020
STATUS: Acknowledged

SECTION 1: BY CONTRACTOR

QUESTION:

An additional transformer is needed for each CPP based on the submittal from Trojan. This EC provides the layout of that equipment which has been coordinated with the electrical contractor.

DRAWING NO.: 400-D-3005 PROCESS MECHANICAL -
FACILITY 400 - DISINFECTION AND PUMPING - SECTION
SPECIFICATION SECTION:

POTENTIAL COST IMPACT:

POTENTIAL SCHEDULE IMPACT:

PROPOSED SOLUTION:

See attached equipment markup.

COMMENTS:

INITIATOR: Menk, Sean/SLC

PRIORITY: Normal

REQUESTED RESPONSE DATE: 9/15/2020

SECTION 2: BY REVIEWER

RESPONSE:

COMMENTS:

REVIEWED BY: Sam Conant


REVIEWED DATE: 10/13/2020

1 2 3 4 5 6



A
B
C
D

GENERAL NOTES

1. PROVIDE 30" PVC PER PIPE SCHEDULE.
2. CONTRACTOR SHALL COORDINATE HEIGHT OF TRANSFORMER PAD WITH UV EQUIPMENT.
3. CONTRACTOR SHALL COORDINATE INSTALLED HEIGHT OF CPP SO THAT THE OIT IS AT 5' ABOVE FINISHED FLOOR.

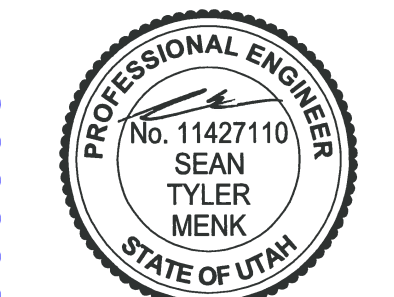

DIGITALLY SIGNED:
02/10/2020

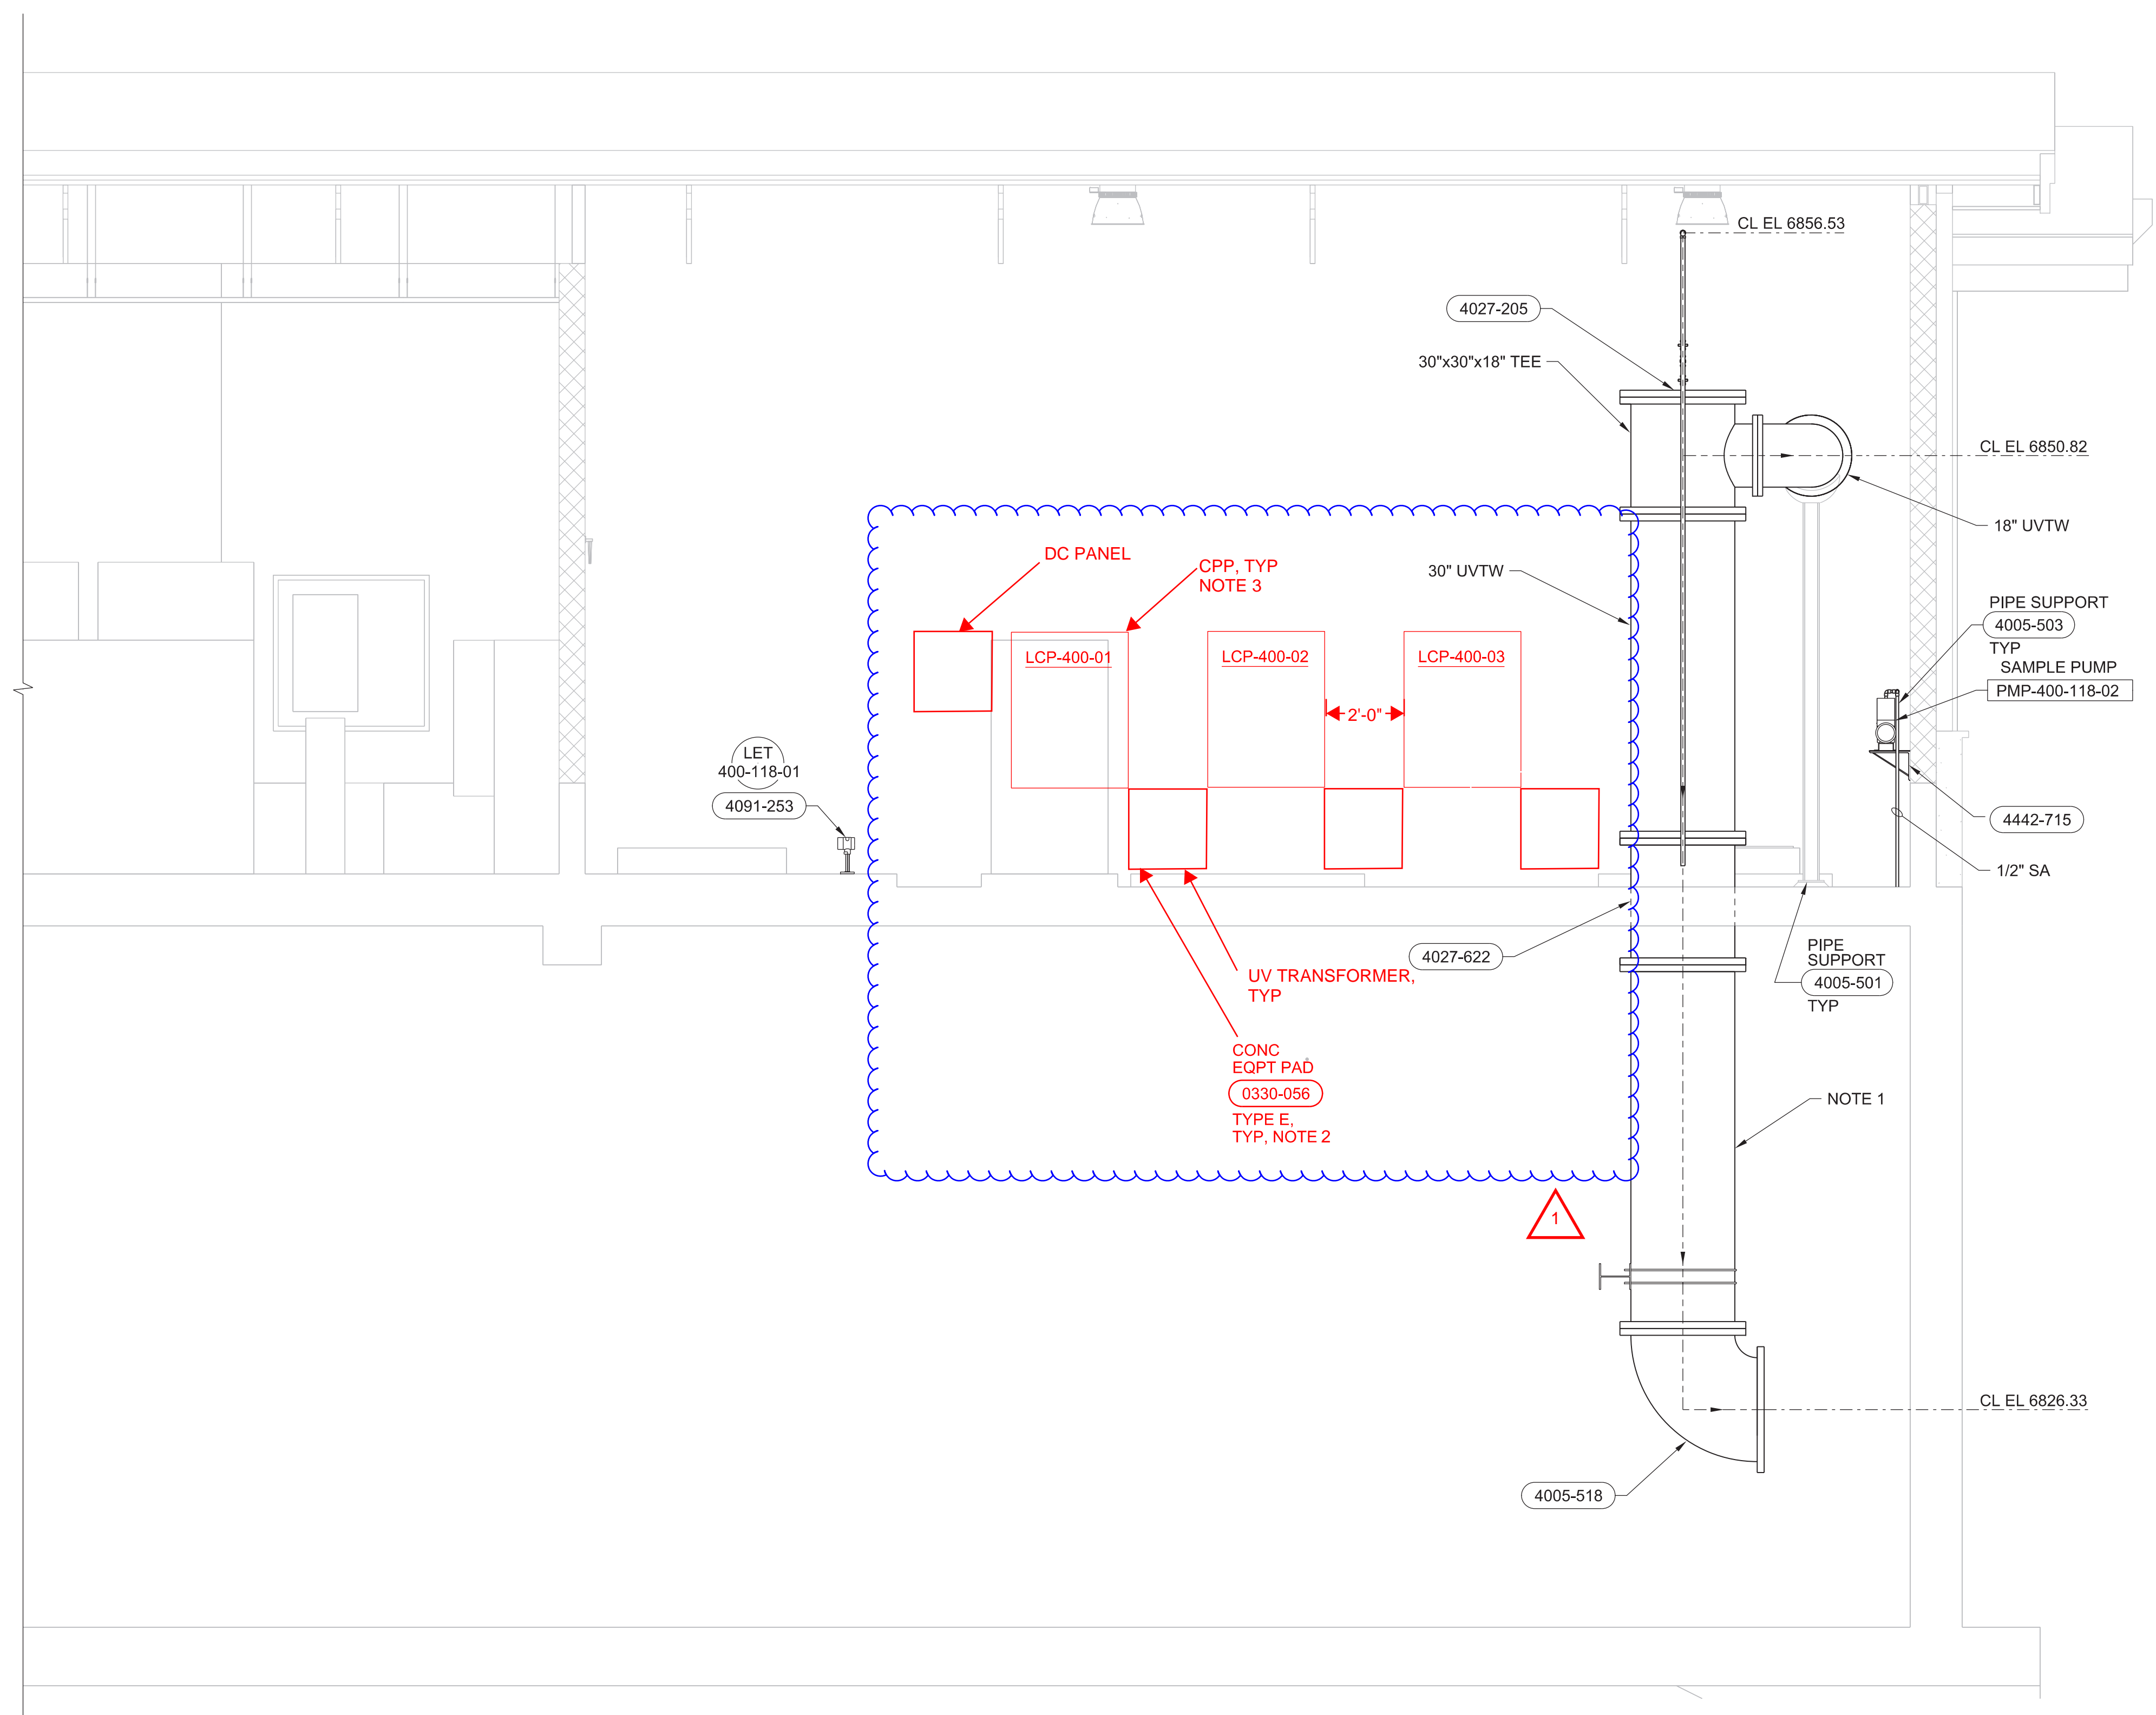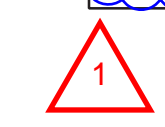

E SECTION
3/8"=1'-0"
400-D-2002

NO.	DATE	REVISION	BY	APVD
1	09/01/2020	ENGINEERING CLARIFICATION #64	SM	APVD
			BY	APVD
			CHK	APVD
			DR	APVD
			S MENK	J ZALLA
			J WILCOX	P SWAIM

ZEHREN AND ASSOCIATES, INC.
ARCHITECTURE, PLANNING, INTERIORS
LANDSCAPE ARCHITECTURE
415 West Center Street, Suite 300
P.O. Box 9797, West Colorado, 81202
970-944-2227 FAX: 970-944-1100
8000 Las Vegas Ave, Suite 101
Las Vegas, Nevada, 89101
702-735-1000

3Kings WTP Phase III Design
Park City Municipal Corporation
Park City, Utah

JACOBS

PROCESS MECHANICAL
FACILITY 400
DISINFECTION AND PUMPING
SECTION

VERIFY SCALE
BAR IS ONE INCH ON ORIGINAL DRAWING.

DATE 02/10/2020
PROJ 694342
DWG 400-D-3005
SHEET 740 of 911

ISSUED FOR CONSTRUCTION

REUSE OF DOCUMENTS: THIS DOCUMENT AND THE IDEAS AND DESIGNS INCORPORATED HEREIN, AS AN INSTRUMENT OF PROFESSIONAL SERVICE, IS THE PROPERTY OF JACOBS AND IS NOT TO BE USED, IN WHOLE OR IN PART, FOR ANY OTHER PROJECT WITHOUT THE WRITTEN AUTHORIZATION OF JACOBS.

© JACOBS 2018. ALL RIGHTS RESERVED.